1700 Broadway, Suite 900 • Denver, Colorado 80290 • (303) 831-8100 • Fax: (303) 831-8208

June 9, 1994

Mr. Marty Faile AFCEE/ERT 8001 Arnold Drive Brooks AFB, Texas 78235-5357

RE: AFCEE Bioventing Test Initiative Final Tables

Dear Marty:

Please find attached final tables and site figures for several sites at which 12 months of bioventing pilot testing have been completed. Specifically, final tables are attached for FE. Warren AFB - Spill Site 1; Hill AFB sites - Building 924, Building 204.1, Building 228, and Building 214; KI Sawyer AFB - IRP Site ST-04 POL Area; Battle Creek ANGB - IRP Site 3 Fire Training Area; Tinker AFB - POL Area 3; Kelly AFB - Site FC-2; Beale AFB - Site 3 and Site 18; and Charleston AFB Site FT-03. AFCEE has previously received final tables for many of these sites. The attached tables have been updated and now include the method detection limits where previously no detection limit was reported. Final figures for Charleston AFB Site FT-03 will be forwarded to you in the near future. Please call me at (303) 831-8100 if you have any questions.

Sincerely,

ENGINEERING-SCIENCE, INC.

Brian Blicker

Environmental Engineer


Brian Blike


c.c.: Doug Downey

File

DISTRIBUTION STATEMENT A

Approved for Public Release Distribution Unlimited

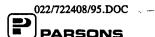

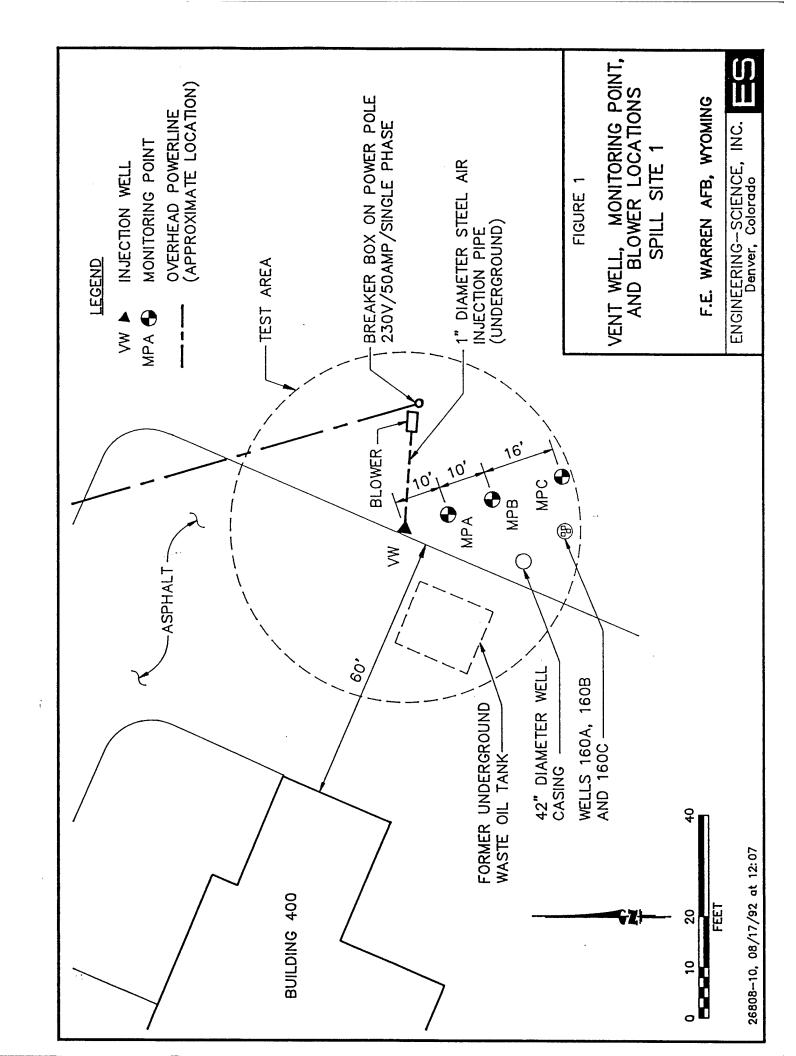

SPILL SITE 1 RESPIRATION AND DEGRADATION RATES F.E. WARREN AFB, WYOMING TABLE 1

	Soil Temperature	(2)	NS ₀ /	NS	NS
1-Year	radation Rate	/kg/year)	13	99	6
	K _o (% O ₂ /min)		0.0001	0.0007	0.0001
	Soil K _o Deg Temperature (% O ₂ /min)	(00)	. 14.3	NS	SN
6-Month ^{b/}	K _o Degradation (% O ₂ /min) Rate	(mg/kg/year)	33	133	20
	K _o (% O ₂ /min)		0.0003	0.002	0.0003
	Soil Temperature (%	(00)	11.8	SN	NS
Initial	Degradation Rate	(mg/kg/year) ^{a/}	362	1835	1449
	K _o (% O ₂ /min)		0.004	0.048	0.018
		Location-Depth	MPA-11	MPB-11	MPC-11

 $^{a\prime}$ Milligrams hydrocarbons per kilogram soil per year. $^{b\prime}$ Assumes moisture content of the soil is the same as the initial readings. $^{c\prime}$ Not sampled.

INITIAL AND 1-YEAR SOIL AND SOIL GAS ANALYTICAL RESULTS F.E. WARREN AFB, WYOMING SPILL SITE 1 TABLE 2


Analyte (Hnite)a		Sai	mple Loca	Sample Location—Depth	म	
rangic (cmrs)	MPA-11		MPB-11	-11	MPC-11	-11
Soil Gas Hydrocarbons	Initial ^{b/}	1-Year	Initial	1-Year	Initial	1-Year
TVH (ppmv)	22	38	42,000	34	4,200	27
Benzene (ppmv)	0.093	< 0.002	480	<0.002	89	< 0.002
Toluene (ppmv)	0.043	0.017	81	0.010	1.6	0.008
Ethylbenzene (ppmv)	0.020	0.058	89	0.058	4.1	0.030
Xylenes (ppmv)	0.079	0.400	320	0.210	19	0.210
	MPA-11	11	MPB-10	-10	MPC-11	-11
Soil Hydrocarbons	Initial ^{d/}	1-Year ^{e/}	Initial	1-Year	Initial	1-Year
		!	;		•	,
TRPH (mg/kg)	29	7.3	920	380	250	1,720
Benzene (mg/kg)	< 0.0019	< 0.003	<0.77	<0.077	<0.38	<3.2
Toluene (mg/kg)	< 0.0022	< 0.003	<0.0>	0.31	<0.44	12
Ethylbenzene (mg/kg)	<0.0016	< 0.003	4.9	<0.077	8.2	<3.2
Xylenes (mg/kg)	0.13	0.0045	34	0.87	51	59
Moisture (%)	19.5	17	22.4	19	20.5	21

^{a/}TRPH=total recoverable petroleum hydrocarbons; mg/kg=milligrams per kilogram;

TVH= total volatile hydrocarbons; ppmv=parts per million, volume per volume; ^{b/}Initial soil gas samples collected on September 11, 1992.

 $^{c/1}$ – Year soil gas samples collected on October 27, 1993. $^{d/1}$ Initial soil samples collected on September 9 and 10, 1992.

e'1-Year soil samples collected on October 25, 1993.

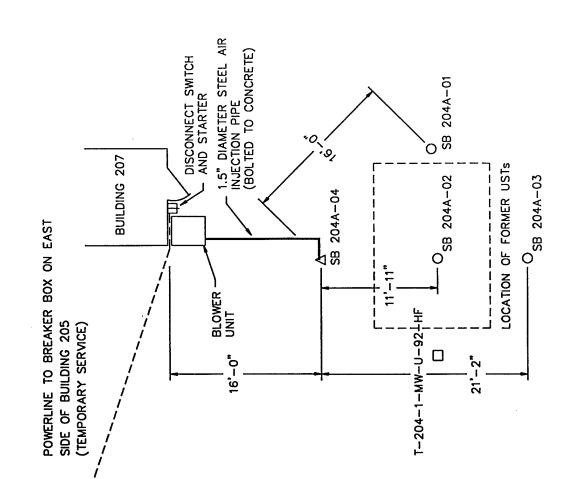

A STREET

LEGEND

- △ CENTRAL VENT WELL
- O VAPOR MONITORING POINT
- ☐ GROUNDWATER MONITORING WELL
- --- POWERLINE

FIGURE 1

SCALE: 1"=10'

BLOWER LOCATION AS-BUILT SITE 204.1

HILL AFB, UTAH

ENGINEERING-SCIENCE, INC.

Denver, Colorado

SITE 204.1 RESPIRATION AND DEGRADATION RATES HILL AFB, UTAH TABLE 1

		Initial (July 1992)		9—9	6-Month (FebMar. 1993)	r. 1993)		1-Year (July 1993)	93)
K _o Degradat (% O ₂ /min) Rate (mg/kg/yea		ion (1)a/b/	Soil K_o Temperature (% O ₂ /min) (°C)	K _o (% O ₂ /min)	Degradation Rate (mg/kg/year) ^{b/}	Soil Temperature (°C)	K _o (% O ₂ /min)	Degradation Rate (mg/kg/year)	Soil Temperature (°C)
.026		0086	/pSN	.0021	790	NS	.0017	640	SN
NS		NS	SN	0.00049	160°	SN	SN	SN	NS
.0062	7	2700	NS	.0008	350	NS	.0005	220	NS
30.	3(3000	NS	NS	SŃ	NS	.0026	470	NS
N	Z ,	NS	NS	.0004	1306/	NS	NS	NS	NS

^{a/} Milligrams of hydrocarbons per kilogram of soil per year.

^{b/} Calculated using moisture content of soil sample collected from the location in July 1993.

c' Vent well.

^d/Well installation was performed by another contractor, no thermocouples were installed. NS=Not Sampled. e/Assumes average moisture content of the soil samples collected in July 1993.

INITIAL AND 1-YEAR SOIL AND SOIL GAS ANALYTICAL RESULTS HILL AFB, UTAH **SITE 204.1** TABLE 2

Analyte (Units) ^{a/}		Sample Locati	ion (Depth, fe	Sample Location (Depth, feet below ground surface)	ind surface)	(6)
	SB204A 04 (10-50)	$(10-50)^{0}$	SB204A - 01 (34-35)	(34–35)	SB204A - 02 (11 - 12)	$\frac{(11-12)}{1}$
Soil Gas Hydrocarbons	Initial	1-Year	Initial	1-Year	Imitial	1-rear
TVH (ppmv)	490	7.6	7.5	0.27	160	1.7
Benzene (ppmv)	.016	.005	.010	<.002	.053	<.003
Toluene (ppmv)	.25	600.	900.	<.002	090.	.004
Ethylbenzene (ppmv)	.17	<.002	<.002	<.002	.085	<.003
Xylenes (ppmv)	.85	.003	<.002	<.002	.31	.003
	SB204A-04 (12.5-13)	12.5–13)	SB204A-01 (9-9.5)	(9-9.5)	SB204A-02 (11-12)	(11–12)
Soil Hydrocarbons	Initial ^{e/}	1-Year	Initial	1-Year	Initial	1-Year
TRPH (mg/kg)	1500	099	370	1750	1000	11200
Benzene (mg/kg)	.023	<.03	600.	<.0003	.031	<.03
Toluene (mg/kg)	.26	<.03	<.005	.0004	.22	<.03
Ethylbenzene (mg/kg)	.78	<.03	.047	<.0003	∞;	<.03
Xylenes (mg/kg)	7.4	<.03	.19	<.0007	7.7	.25
Moisture (%)	ASN	5.0	4.8 ^{h/}	3.0	NS	15.0

a/TVH= total volatile hydrocarbons; ppmv=parts per million, volume per volume;

TRPH=total recoverable petroleum hydrocarbons; mg/kg=milligrams per kilogram.

^{b/}Vent well.


^{&#}x27;Initial soil gas samples collected on 7/7/92.

^d/₁ – Year soil gas samples collected on 7/19/93. e'Initial soil samples collected by Montgomery – Watson, Inc. from 5/4/92 to 5/7/92.

f 1-Year soil samples collected on 8/10/93.

g/NS=Not Sampled.

¹⁴ Average soil moisture content of analytical samples collected from borehole SB204A-01.

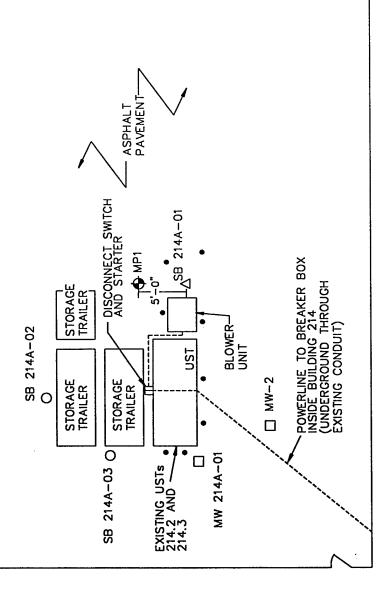

BUILDING 214

LEGEND

- △ CENTRAL VENT WELL
- O VAPOR MONITORING POINT
- ☐ GROUNDWATER MONITORING WELL
- ----- POWERLINE
- BALLARDS
- SOIL GAS PROBE

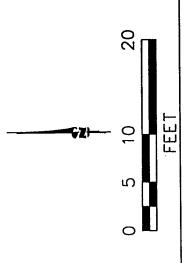


FIGURE 1

BLOWER LOCATION AS-BUILT SITE 214.1

HILL AFB, UTAH

ENGINEERING-SCIENCE, INC.

Denver, Colorado

SITE 214.1 RESPIRATION AND DEGRADATION RATES HILL AFB, UTAH TABLE 1

		Tillial (July 1992)		M-0	o-Monin (rep Mar. 1993)	I. 1995)	T	l – rear (July 1993)	(5)
	Y,	Degradation	Soil	K _o	Degradation	Soil	X,	Degradation	Soil
	$(\% O_2/min)$	Rate	Temperature	(% O ₂ /min)	Rate	Temperature	(% O ₂ /min)	Rate	Temperature
Location (Depth, feet bgs)		(mg/kg/year) ^{a/}	(၁၀)		(mg/kg/year) ^{b/}	(၁၀)	•	(mg/kg/year) ^{b/}	(၃)
				!					

 $0.0051^{d/}$ SB214A-01 (5-60)^{c/}

NSe/

540

.00025

27

.00025

SS

SZ

27

^a/Milligrams of hydrocarbons per kilogram of soil per year.


b/ Assumes moisture content of the soil is the same as the initial level at SB214A-01.

d'Temporary vapor probe MP-1 was installed at 12 feet below grade 5 feet north of SB214A-01 for initial testing.

e' Well installation was performed by another contractor, no thermocouples were installed. NS=Not Sampled.

SITE 214.1 INITIAL AND 1—YEAR SOIL AND SOIL GAS ANALYTICAL RESULTS HILL AFB, UTAH TABLE 2

TRPH=total recoverable petroleum hydrocarbons; mg/kg=milligrams per kilogram. b' Initial soil gas sample collected on 7/7/92. c' 1—Year soil gas sample collected on 7/19/93. d' Initial soil samples collected by Montgomery—Watson, Inc. on 11/1/91. e' 1—Year soil sample collected on 8/3/93. f' NS=Not Sampled. a/ TVH= total volatile hydrocarbons; ppmv=parts per million, volume per volume;

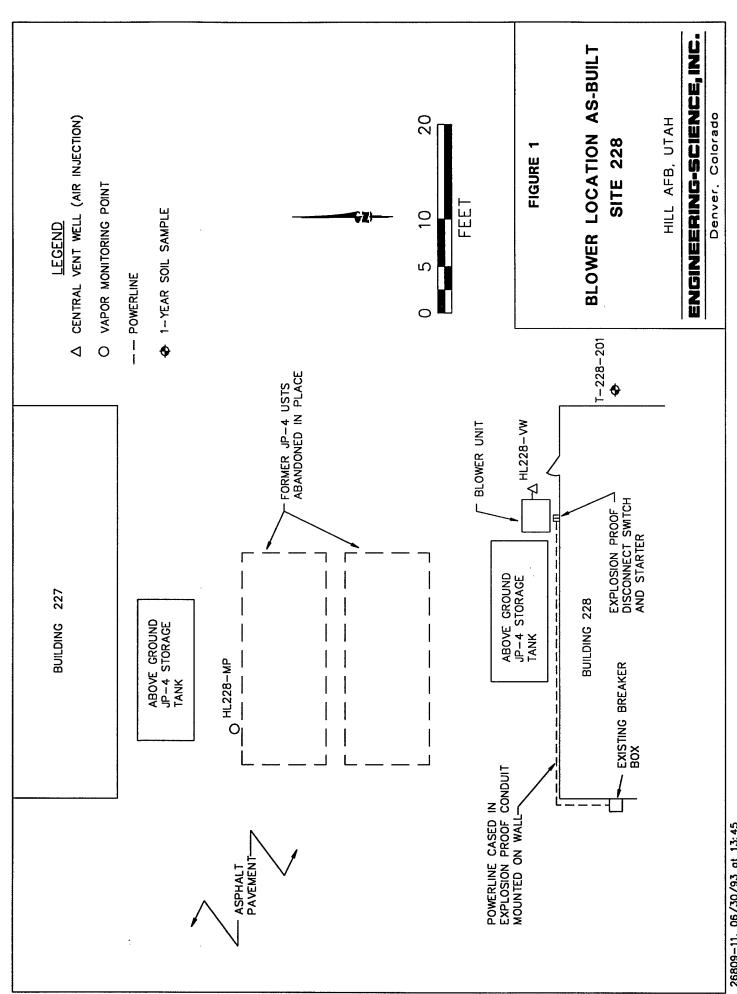

26809-11. 06/30/93 at 13:45

SITE 228 RESPIRATION AND DEGRADATION RATES HILL AFB, UTAH TABLE 1

				_,
33)	Soil	Temperature	ဉ	SN
1-Year (July 1993)	Degradation	Rate	(mg/kg/year) ^{0/}	17
+	K,	(% O ₂ /min)		.00007
. 1993)	Soil	Temperature (% O ₂ /min)	ပ္	SN
6-Month (FebMar. 1993)	Degradation	-	(mg/kg/year)"	10
6-Mo	$ m K_o$	(% O ₂ /min,		.00004
2)	Soil	Temperature (% O ₂ /min,	(2C)	/pSN
Initial (July 1992)	Degradation	Rate (2)	(mg/kg/year)"	NN .
	Ж	(% O ₂ /min)		NS^{α_j}
			Location (Depth, feet bgs)	HL228-VW (10-40)

SN

470

.0019

SS

250

.001

SN

2200

600.

HL228-MP (28-29)

^{a/} Milligrams of hydrocarbons per kilogram of soil per year.
^{b/} Assumes moisture content of the soil is the same as the initial level at HL228-VW.
^{c/} NS=Not Sampled.
^{d/} Well installation was performed by another contractor, no thermocouples were installed.

INITIAL AND 1-YEAR SOIL AND SOIL GAS ANALYTICAL RESULTS HILL AFB, UTAH TABLE 2 SITE 228

Analyte (Units) ^{a/}	Sample Location (Depth, feet below ground surface)	(Depth, fe	set below ground surfa	id surface)
Soil Gas Hydrocarbons	Initial ^b $1-\text{Year}^{\alpha}$	1-Year ^{c/ d/}	Initial ^d	$1-Year^{d}$
TVH (ppmv)	42	27	2700	12
Benzene (ppmv)	90°	.03	1.55	.012
Toluene (ppmv)	600.	.0135	4.4	.044
Ethylbenzene (ppmv)	.002	.019	1.7	.013
Xylenes (ppmv)	.018	.205	9.45	.051
	HI 228 – VW (27 5 – 28)	5-28)	HI 228-MP (28-28 5)	28-28.5)
Soil Hydrocarbons	Initial ^e / 1-	1-Year	Initial	1-Year®
TRPH (mg/kg)	2000	<5.4	6,500	NS _h /
Benzene (mg/kg)	1.2	<.0006	0.08	SN
Toluene (mg/kg)	12	> 0000	6.3	SN
Ethylbenzene (mg/kg)	6.1	> 00000	8.1	SN
Xylenes (mg/kg)	220	<.0008	260	SN
Moisture (%)	11.7^{ij}	8.0	NS	NS

TRPH=total recoverable petroleum hydrocarbons; mg/kg=milligrams per kilogram. a/ TVH= total volatile hydrocarbons; ppmv=parts per million, volume per volume;

b/ Initial soil gas samples collected on 7/6/92 and 7/7/92.

o' 1-Year soil gas samples collected on 7/19/93.


d' Average of two duplicate samples.

e' Initial soil samples collected by Montgomery-Watson, Inc. on 5/18/92.

^{1 1-}Year soil samples collected at location T-228-201 (28.5-29) on 9/11/93.

^{8/} Sample could not be collected due to presence of underground utilities. In NS=Not Sampled.

1/ Average soil moisture content from samples collected at HI 228 - VW.

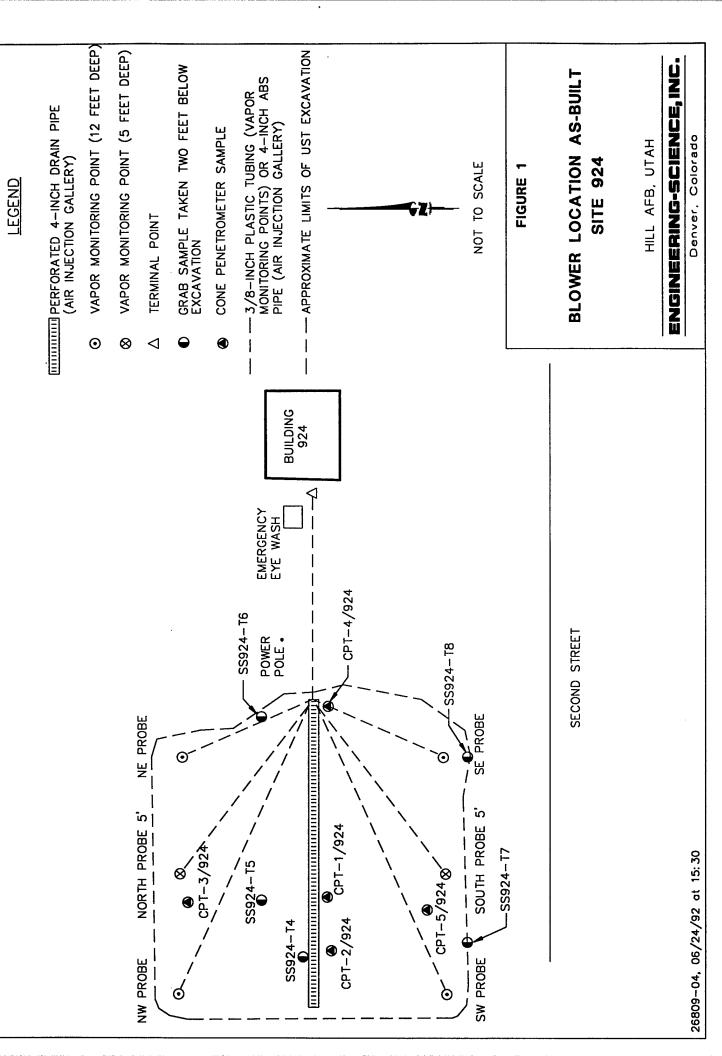

SITE 924
RESPIRATION AND DEGRADATION RATES HILL AFB, UTAH TABLE 1

uly 1993)	ation Soil e Temperature (°C)	28 NS	64 NS	NS NS	32 NS
1-Year (July 1993)	$(\% O_2/\min)$ Degradation Rate $(\% O_2/\min)$ (mg/kg/year) ^{b/}	.00008	.00018	NS	60000.
(993)	Soil Temperature (°C)	NS	NS	SN	SN
6-Month (March 1993)	Degradation Rate (mg/kg/year) ^{b/}	NS	430	SN	85
1-9	K _o (% O ₂ /min)		.0012	/PSN	.00024
2)	Soil K _o Temperature (% O ₂ /min)	NSO	SN	NS	NS
Initial (July 1992)	Degradation Rate (mg/kg/year) ^{a/ b/}	5000	4600	3200	390
	K _o (% O ₂ /min)	.014	.013	600.	.0011
	Location (Depth, feet bgs)	HL924-VW (12)	HL924-SE (12)	HL924-S(5)	HL924-SW (12)

^{a/} Milligrams of hydrocarbons per kilogram of soil per year.

^{b/} Calculated using average moisture content of soil samples collected from Site 924.5, north of Bldg 924.

^{c/} Well installation was completed by another contractor, no thermocouples were installed. NS=Not Sampled.

^{d/} Monitoring point HL924-S was destroyed during site construction activity in Fall 1992.

INITIAL AND 1-YEAR SOIL AND SOIL GAS ANALYTICAL RESULTS HILL AFB, UTAH TABLE 2 **SITE 924**

a/TVH= total volatile hydrocarbons; ppmv=parts per million, volume per volume;

TRPH=total recoverable petroleum hydrocarbons; mg/kg=milligrams per kilogram.


^b/Initial soil gas samples collected on 7/7/92.

0/1-Year soil gas samples collected on 7/19/93.

d'Average of two duplicate samples.

No sample could be collected due to subsurface obstruction; NS=Not Sampled.

Initial soil samples collected by D+W Construction on 5/19/92. 8/1-Year soil samples collected by Montgomery-Watson, Inc. on 11/19/92.

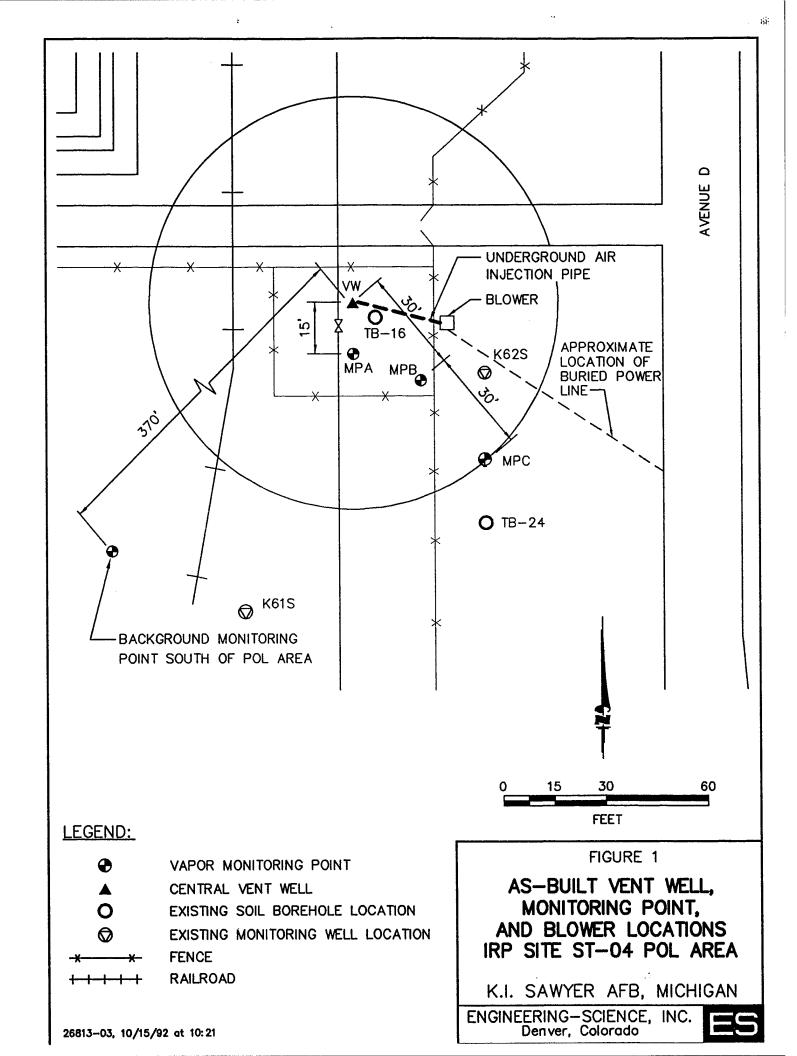

IRP SITE ST-04 POL AREA RESPIRATION AND DEGRADATION RATES K.I. SAWYER AFB, MICHIGAN TABLE 1

(mg/kg/year) ^{al} (°C) (mg/kg/year) (°C) 634 12.2 0.0028 780 16.7 10 NS ^{cl} 0.00013 14 NS 423 NS 0.00048 760 NS 477 NS 0.0025 450 NS NS NS 0.0015 240 NS 159 NS 0.0011 180 NS	 K _o % O ₂ /min)	Degradation Rate	Soil Temperature	K _o (% O ₂ /min)	Degradation Rate	Soil Temperature	K _o (% O ₂ /min)	Degradation Rate	Soil Temperature
634 12.2 0.0028 780 16.7 NS 0 10.00013 14 NS 0 10.00013 14 NS 0 0.000074 16 8.9 0.0 0.0025 450 NS NS 0.0025 A50 NS NS 0.0015 NS NS 0.0011 180 NS 0	 ,	(mg/kg/year) ^{a/}	(°C)		(mg/kg/ycar)	(C)		(mg/kg/year)	(%)
10 NS° 0.00013 14 NS 0 14 8.9 0.000074 16 8.9 0.0 423 NS 0.0025 450 NS 477 NS 0.0015 240 NS 0 159 NS 0.0011 180 NS 0	0.0026		12.2	0.0028	780	16.7		1700	32.8
14 8.9 0.000074 16 8.9 0.0 423 NS 0.0048 760 NS 477 NS 0.0025 450 NS NS NS 0.0015 240 NS 0 159 NS 0.0011 180 NS 0	0.00049	10	NS ₀	0.00013	14	SN		100	SN
423 NS 0.0048 760 NS 477 NS 0.0025 450 NS NS NS 0.0015 240 NS 0 159 NS 0.0011 180 NS 0	0.00066	14	8.9	0.000074	16	8.9	_	20	8.7
477 NS 0.0025 450 NS NS 0.0015 240 NS 0 159 NS 0.0011 180 NS 0	0.0039		SN	0.0048	160	NS	0.0059	1400	SN
NS 0.0015 240 NS (159 NS 0.0011 180 NS (159 NS 0.0011 180 NS (159 NS 0.0011 NS (150 NS	0.0020		SN	0.0025	450	NS	0.0039	790	SN
159 NS 0.0011 180 NS (SN	SN	SN	0.0015	240	SN	0.00087	200	SN
	0.0010	159	SN	0.0011	180	SN	0.00015	35	SN

 $^{a\prime}$ Milligrams hydrocarbons per kilogram soil per year. $^{b\prime}$ Average moisture between initial and 1—Year readings is used for degradation rate calculation. $^{c\prime}$ Not sampled.

INITIAL AND 1-YEAR SOIL AND SOIL GAS ANALYTICAL RESULTS K.I. SAWYER AFB, MICHIGAN IRP SITE ST-04 POL AREA TABLE 2


10		Sa	mple Loca	Sample Location-Depth	th	
Analyte (Units) ²⁴		(fee	t below gr	(feet below ground surface)	(33	
	MΛ	W	MPA	MPA-35	MPC-15	MPB-35
Soil Gas Hydrocarbons	Initial ^{b/}	1-Year	Initial	1-Year	Initial	1-Year
TVH (ppmv)	48,000	8.6	70,000	092	5,200	2,700
Benzene (ppmv)	. 240	0.004	930	< 0.051	7.6	<0.20
Toluene (ppmv)	140	0.013	390	< 0.051	4.4	<0.20
Ethylbenzene (ppmv)	10	0.012	17	< 0.051	<0.55	5.0
Xylenes (ppmv)	17	0.020	28	0.18	0.80	14
	MA	VW-16	MPA-38	-38	MPB-36	-36
Soil Hydrocarbons	Initial ^{d/}	1-Year ^e	Initial	1-Year	Initial	1-Year
TRPH (mg/kg)	1,700	54	029	4,200	1,400	3,620
Benzene (mg/kg)	>0.66	<0.039	<0.65	<0.08	9:9>	<0.34
Toluene (mg/kg)	5.7	< 0.048	5.7	<0.099	110	<0.41
Ethylbenzene (mg/kg)	2.5	<0.04	1.6	<0.082	25	⊣
Xylenes (mg/kg)	7.8	<0.17	4.6	<0.35	70	23
Moisture (%)	8.8	3.0	19.4	5.8	11.7	9.3

^{a/}TRPH=total recoverable petroleum hydrocarbons; mg/kg=milligrams per kilogram; TVH = total volatile hydrocarbons; ppmv=parts per million, volume per volume; b/Initial soil gas samples collected on September 21, 1992.

c/Final soil gas samples collected on October 7, 1993.

e/ Initial soil samples collected on September 14-15, 1992.

f/ Final soil samples collected on September 23, 1993.

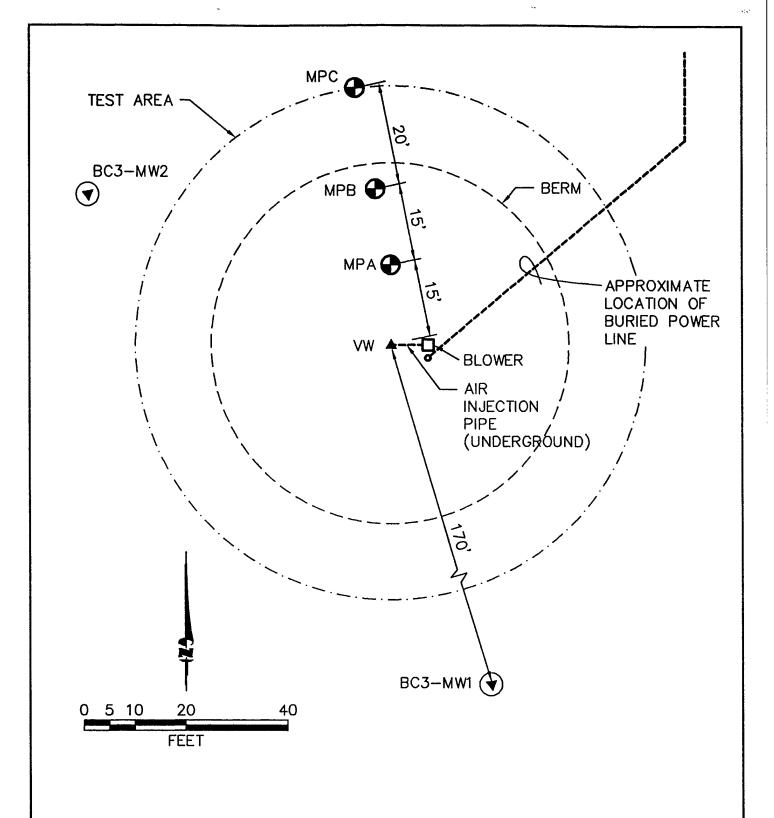

LEGEND

MPA 🕕

MONITORING POINTS

VW 🔺

CENTRAL VENT WELL (AIR INJECTION)

BC3-MW1

EXISTING GROUNDWATER
MONITORING WELL (USED
FOR BACKGROUND MONITORING POINT)

26814-06, 10/27/92 at 10:22

FIGURE 1

AS-BUILT
VENT WELL, VAPOR MONITORING
POINT, AND BLOWER LOCATIONS
IRP SITE 3
FIRE TRAINING AREA

Battle Creek ANGB, Michigan

ENGINEERING-SCIENCE, INC. Denver, Colorado



RESPIRATION AND DEGRADATION RATES BATTLE CREEK ANGB, MICHIGAN TABLE 1

	Soil Temperature (°F)	89	i ! i i	
1-Year	Degradation Rate (mg/kg/year)	2270 1143 	307	13
	· K _o (% O ₂ /min)	0.0106	0.0011	0.0000
	Soil Temperature (°F)	54 56	1 1	1 1
6-Month ^{b/}	Degradation Rate (mg/kg/year)	1173 866 	253 759	12 23
	K _o (% O ₂ /min)	0.0048	0.0010	0.00005
	Soil Temperature (°F)	67	1 1	† 1 †
Initial	Degradation Rate mg/kg/year) ^{a/}	3683 2028 580	280	
	K _o (% O ₂ /min)	0.015 0.007 0.002	0.002	!!
	Location-Depth	MPA-8 MPA-17 MPA-27	MPB-8 MPB-17	MPC-8 MPC-17

 $^{a\prime}$ Milligrams hydrocarbons per kilogram soil per year $^{b\prime}$ Assumes moisture content of the soil is the same as the initial readings.

INITIAL AND 1-YEAR SOIL AND SOIL GAS ANALYTICAL RESULTS BATTLE CREEK ANGB, MICHIGAN IRP SITE 3 FIRE TRAINING AREA TABLE 2

		Saı	nple Locai	Sample Location—Depth	_	
Analyte (Units) ^{a/}		(fee	t below gro	(feet below ground surface)		
,	MA	^	MPA-8	8-1	$MPC-17^{b'}$	-17 ^{b/}
Soil Gas Hydrocarbons	Initial ^{c/}	1-Year ^d	Initial	1-Year	Initial	1-Year
TVH (ppmv)	29,000	1.5	3,600	21	88	1.3
Benzene (ppmv)	120	< 0.002	29	< 0.002	0.057	< 0.002
Toluene (ppmv)	50	< 0.002	3.3	900.0	0.036	<0.002
Ethylbenzene (ppmv)	4.4	< 0.002	3.9	< 0.002	< 0.010	< 0.002
Xylenes (ppmv)	22	< 0.002	11	<0.002	0.010	<0.002
	8-WV	8-	MPA-7	2-1	MPB-18	-18
Soil Hydrocarbons	$Initial^U$	1-Year ^g	Initial	1-Year	Initial	1-Year
TRPH (mg/kg)	15,000	3,140	6,800 ^{b/}	1,580	120	<5.4
Benzene (mg/kg)	<0.13	< 0.065	<0.32	< 0.0005	0.004	< 0.0005
Toluene (mg/kg)	7.0	< 0.065	0.32	< 0.0005	0.004	< 0.0005
Ethylbenzene (mg/kg)	2.8	< 0.065	4.4	< 0.0005	<0.0005	< 0.0005
Xylenes (mg/kg)	23.0	<0.091	8.9 ^b /	<0.0007	<0.0009	0.0017
Moisture (%)	7.0	4.0	C.C	2.0	0.7	Ç.

a TRPH=total recoverable petroleum hydrocarbons; mg/kg=milligrams per kilogram; TVH = total volatile hydrocarbons; ppmv=parts per million, volume per volume;

CaCO₃=calcium carbonate; TKN=total Kjeldahl nitrogen. b/Results averaged with duplicate sample.

o'Initial soil gas samples collected on September 11, 1992.

^d/₁-Year soil gas samples collected on October 27, 1993.

e'ND=not detected.

^IInitial soil samples collected on September 9 and 10, 1992.

9/1-Year soil samples collected on October 25, 1993.

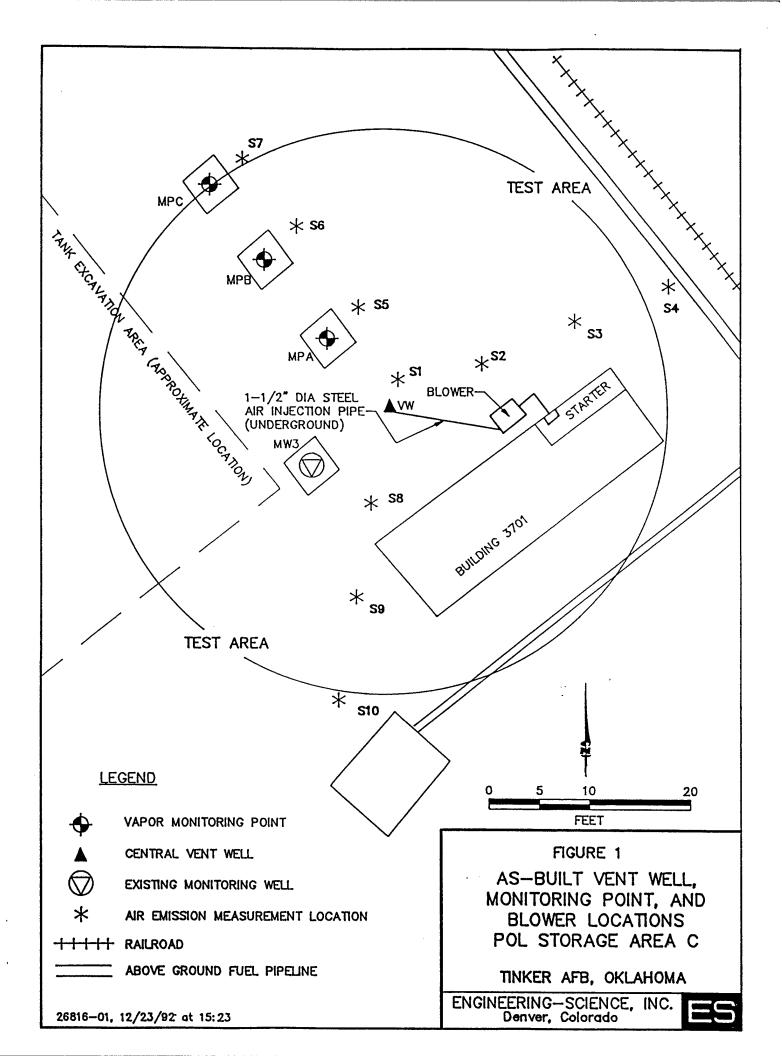


TABLE 1
POL AREA 3
RESPIRATION AND DEGRADATION RATES
TINKER AFB, OKLAHOMA

		Initial			6-Month ^{b/}			1-Year	
	X,	Degradation	Soil	ಸ್ಯ	Degradation	Soil		Degradation	Soil
ocation-Depth	(% O ₂ /min)	Rate (mg/kg/year) ^{a/}	Temperature (°C)	(% O ₂ /min)	Rate (mg/kg/year)	Temperature (°C)	(% O ₂ /min)	Rate (mg/kg/year)	Temperature (°C)
MPA-5	0.0053	006	17.3	0.0020	320	15.1	0.00088	120	9.5
MPA-10	NS _{c/}	SN	SN	SN	SN	NS	0.00013	30	SN
MPA-15	0.0021	420	20.1	0.000065	13	18.6	0.000093	19	16.2
PB-5	NS	SN	SN	SN	NS	NS	0.00099	170	NS
PB-10	0.0026	610	SN	0.00056	130	SN	0.0011	260	SN
MPB-15	0.0024	480	NS	0.00014	78	SN	0.00064	130	NS
PC-5	SN	SN	SN	SN	SN	SN	0.0017	250	SN
MPC-10	0.0031	720	NS	0.00055	130	SN	0.0017	400	SN
MPC-15	0.0025	200	SN	0.00043	87	SN	0.0011	220	SN

Milligrams hydrocarbons per kilogram soil per year
 Moisture content an average of initial and final readings.
 NS = Not Sampled.

REV01/6/8/94

TABLE 2
POL AREA 3
INITIAL AND 1—YEAR SOIL AND SOIL GAS ANALYTICAL RESULTS TINKER AFB, OKLAHOMA


Analyte (Units) ^{a/}		Sa. (fee	mple Loc t below g	Sample Location—Depth (feet below ground surface)	th ice)	
	>	ΛM	MF	MPA-5	MPC-10	MPC-15
Soil Gas Hydrocarbons	Initial ^{b/}	1-Year	Initial	1-Year	Initial	1-Year
TVH (ppmv)	940	2.4	3,500	34	30,000	530
Benzene (ppmv)	<0.21	0.003	100	<0.002	59	0.049
Toluene (ppmv)	6.3	<0.002	120	0.052	180	< 0.025
Ethylbenzene (ppmv)	1.1	0.005	17	0.071	15	2.1
Xylenes (ppmv)	3.2	0.017	55	0.23	51	2.9
	X	VW-5	MF	MPA-5	MPB-5	3-5
Soil Hydrocarbons	Initial ^{d/}	1-Year	Initial	1-Year	Initial	1-Year
TRPH (mg/kg)	1,100	<5.5	2800	<5.8	5	<5.6
Benzene (mg/kg)	<2.7	<0.0006	4.3	0.003	<0.0006	<0.0006
Toluene (mg/kg)	120	0.0016	15	<0.0029	<0.0008	0.0013
Ethylbenzene (mg/kg)	140	<0.0006	19	0.014	< 0.0005	<0.0006
Xylenes (mg/kg)	130	<0.0008	120	0.11	<0.001	< 0.0008
Moisture (% by wt.)	9.6	8.7	10.7	13.1	7.8	11.3

a' TRPH=total recoverable petroleum hydrocarbons; mg/kg=milligrams per kilogram; TVH= total volatile hydrocarbons; ppmv=parts per million, volume per volume;

CaCO₃=calcium carbonate; TKN=total Kjeldahl nitrogen. ^b Initial soil gas samples collected on November 14, 1992.

d/ Initial soil samples collected on November 11 and 12, 1993.

e' 1-Year soil samples collected on January 27, 1994.

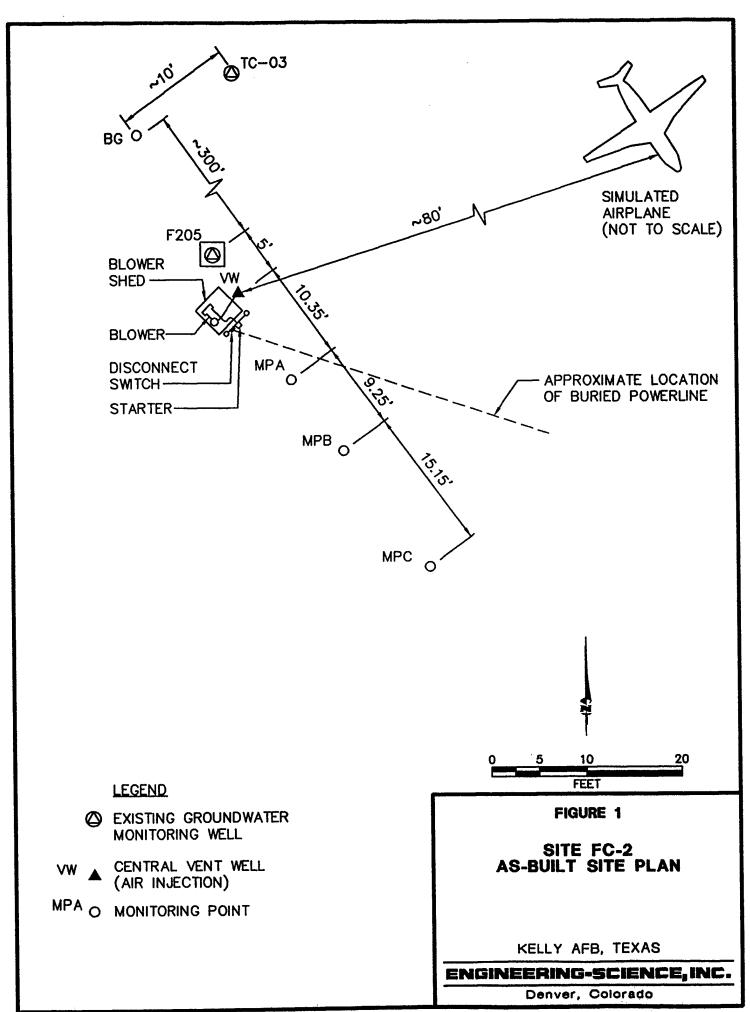

070N0007 00 /00 /01 at 10.50

RESPIRATION AND DEGRADATION RATES KELLY AFB, TEXAS SITE FC-2 TABLE 1

	Initi	Initial = December 1992	1992	- 9	6-Month = June 1993	1993	1-1	1-Year = January 1994	1994
	W.	Degradation	Soil	χ,	Degradation		$ m K_o$	Degradation	Soil
Location-Depth (% O ₂ /min) Rate	(% O ₂ /min)	Rate	Temperature	(% O ₂ /min)	Rate ^b /	Temperature (% O ₂ /min)	(% O ₂ /min)	Rate	Temperature
(feet bgs)	. 	(mg/kg/year) ^{a/}	(၁ွ)	•	(mg/kg/year)	(₀ C)		(mg/kg/year)	(၄)
MPA-4	NSo	NS	18.0	NS	SN	26.9	SN	SN	16.7
MPA-13.5	0.040	8100	24.9	0.013	2600	26.4	0.0058	1200	26.4
MPB-9	0.021	3500	NS	0.0039	480	NS	0.0023	180	SN
MPB-13.5	0.025	4200	NS	0.0019	230	NS	0.0083	650	NS
MPC-13.5	0.040	/p004/	SN	0.029	3600 ^{d/}	NS	0.022	1700 ^{d/}	NS

Milligrams hydrocarbons per kilogram soil per year.
 Assumes moisture content of the soil is average of initial and final moistures.
 Not Sampled.
 Degradation rate calculated assuming MPC-13.5 soil moisture content the same as MPB-13.5.

INITIAL AND 1-YEAR SOIL AND SOIL GAS ANALYTICAL RESULTS KELLY AFB, TEXAS SITE FC-2 TABLE 2

Analyte (Hnits) ^{a/}		Sar	nple Local	Sample Location – Depth feet below ground surface	h (e.	
(2000) 200	MA		MPA-13.5	-13.5	MPC-13.5	-13.5
Soil Gas Hydrocarbons	Initial ^{5/}	1-Year	Initial	1-Year	Initial	1-Year
,		•		(1	
TVH (ppmv)	4,200	2.0	16,000	86	17,000	200
Benzene (ppmv)	14	<0.002	58	<0.004	43	< 0.025
Toluene (ppmv)	7.4	0.02	20	0.28	18	1.5
Ethylbenzene (ppmv)	7	0.008	24	0.093	24	0.35
Xylenes (ppmv)	5.4	0.029	19	0.29	22	0.71
	VW-15	-15	MPA-14	-14	MPB-14	-14
Soil Hydrocarbons	Initial ^{d/}	1-Year	Initial	1-Year	Initial	1-Year
TRPH (mg/kg)	280	34.1	3,500	73.5	1,100	83.8
Benzene (mg/kg)	<0.38	<0.0006	<1.5	0.001	<0.38	<0.084
Toluene (mg/kg)	9.1	0.0056	12.0	0.027	2.9	0.36
Ethylbenzene (mg/kg)	<0.31	<0.0006	<1.2	0.001	<0.32	<0.084
Xylenes (mg/kg)	11.0	0.0009	40.0	0.0059	15.0	<0.12
Moisture (%)	20.0	16.3	19.4	19.2	20.8	25.9

TRPH=total recoverable petroleum hydrocarbons; mg/kg=milligrams per kilogram. ^aTVH = total volatile hydrocarbons; ppmv=parts per million, volume per volume;

b/Initial soil gas samples collected in December 1992. c/1 – Year soil gas samples collected in January 1994. d/Initial soil samples collected in December 1992. e/1 – Year soil samples collected in January 1994.

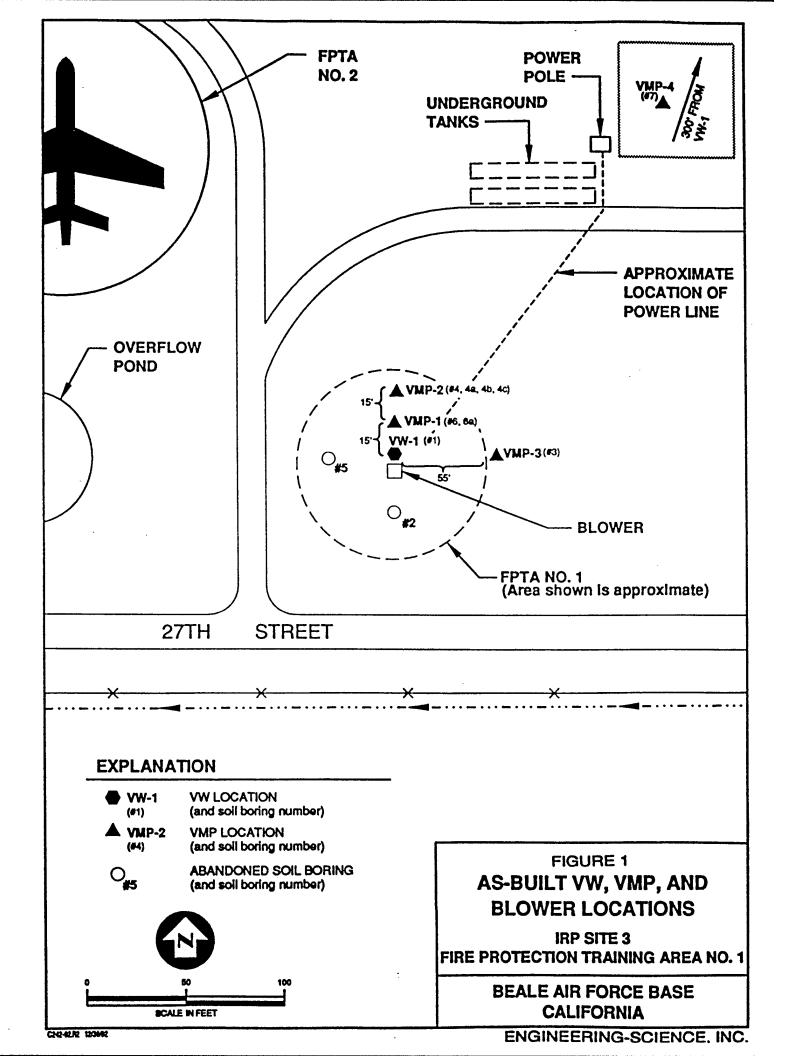


TABLE 1 SITE 3 RESPIRATION AND DEGRADATION RATES BEALE AFB, CALIFORNIA

		÷	VMP1-14 VMP1-24	VMP2-8 VMP2-14 VMP2-24	VMP3 – 8 VMP3 – 14 VMP3 – 24	VMP4-8 VMP4-15 VMP4-24	VW1

Notes:

/a = Not Sampled.

/b = Milligrams hydrocarbons per kilogram soil per year. /c = Assumes moisture content of the soil is average of initial and final moistures. /d = Not Applicable (Background Well).

INITIAL AND 1-YEAR SOIL AND SOIL GAS ANALYTICAL RESULTS BEALE AFB, CALIFORNIA TABLE 2 SITE 3

Anslyde (I Inits) ^{a/}			Sample Locations – Depth (feet below ground surface)	ions – Depth		
randly to (carry)	M	VW-1	VMP1-8	8-	VMP3-14	-14
Soil Gas Hydrocarbons	Initial ^{b/}	1-Year	Initial	1-Year	Initial	1-Year
		:		9	,	ţ
TVH (ppmv)	4,000	7.4	4,800	780	150	11
Benzene (ppmv)	3.1	<0.002	3.8	0.81	0.054	0.004
Toluene (ppmv)	2.2	<0.002	3.6	1.8	0.016	<0.002
Ethylbenzene (ppmv)	1.4	<0.002	0.72	2.6	<0.002	0.003
Xylenes (ppmv)	3.4	0.002	3.6	5.9	0.005	0.011
	MA	VW1-10	VMP1-9	-6	VMP2-9	6
Soil Hydrocarbons	Initial ^d	1-Year ^{e/}	Initial	1-Year	Initial	1-Year
TRPH (mg/kg)	25,000	22,100	7,400	8,010	6,800	41.2
Benzene (mg/kg)	3.2	<0.078	<0.82	<0.32	<1.5	<0.077
Toluene (mg/kg)	8.2	<0.078	3.1	<0.32	3.1	<0.077
Ethylbenzene (mg/kg)	8.2	<0.078	1.7	0.94	<1.3	0.24
Xylenes (mg/kg)	38	0.26	5.8	3.1	7.8	0.76
Moisture (%)	21.8	20.4	27.3	23.0	22.2	19.2

^a/ TVH = total volatile hydrocarbons; ppmv = parts per million, volume per volume;


TRPH = total recoverable petroleum hydrocarbons; mg/kg = milligrams per kilogram.

^{b/} Initial soil gas samples collected on October 29, 1992.

c/ Final soil gas samples collected on March 22, 1994.

d'Initial soil samples collected on October 19-23, 1992.

e' Final soil samples collected on March 15, 1994.

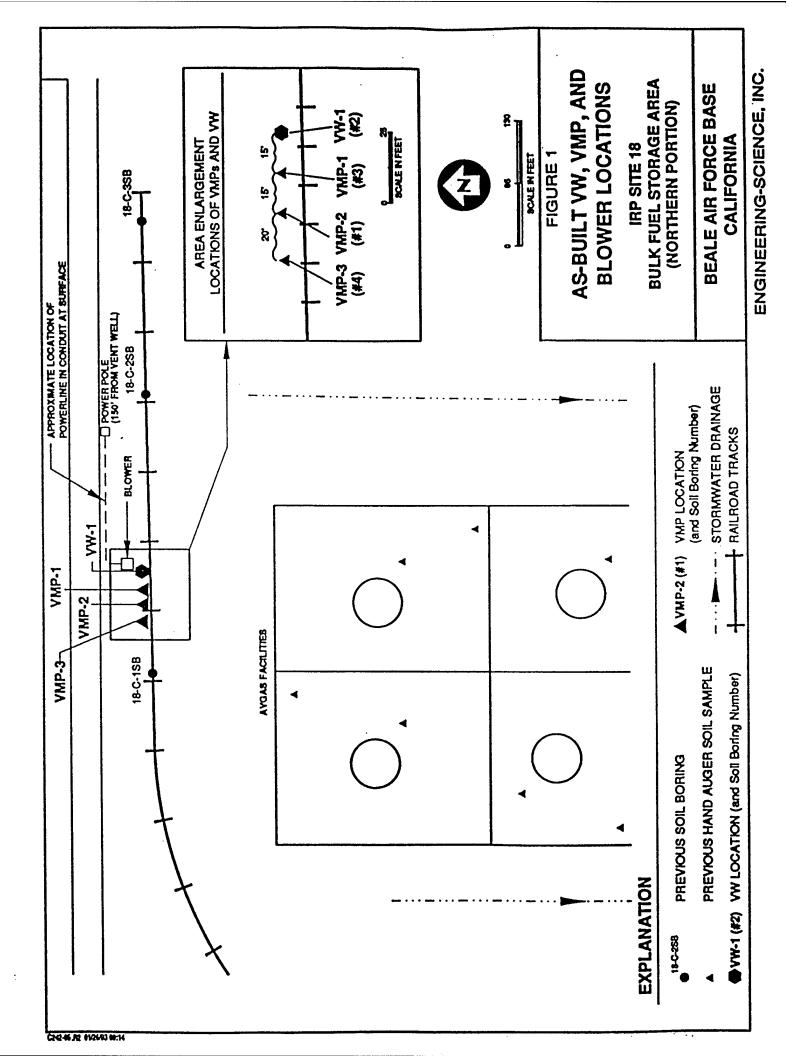

SITE 18
RESPIRATION AND DEGRADATION RATES
BEALE AFB, CALIFORNIA TABLE 1

	II.	Initial - November 1992	1992		6-Month-July 1993	1993	1	1-Year-January 1994	1994
	K	Degradation	Soil	K	Degradation	Soil	K	Degradation	Soil
	(%O ₂ /min)	Rate	Temperature	(%O ₂ /min)	$Rate^{k}$	Temperature	(%O ₂ /min)	Rate	Temperature
Location-Depth	, ,	(mg/kg/year) ^{/b}	(°C)		(mg/kg/year)	(00)		(mg/kg/year)	(၃)
	0070		7 10		400		0.0035	940	16.1
VMP1-0	0.0400		1.17	1,000	0 0			140	NO.
VMP1-11	0.0048	ē	SN		20	SK		140	CNI
VAKD1-30	K/2/a		SN		0	SN	0.00017	50	SN
27 LUJ 47	ON.	O'N	20.1	SZ	SN	19.9	NS	SN	20.5
	CX		1	1					
3_cana	V Z		S.Z.	0.0029	0	SN	0.0012	10	SN
0-7-INI A			OIN	٠		SZ		10	SN
VMP2-11	0.0037		ON.	2.5					017
VMP2-30	SN		SN		NS				SN
25 Z THI 1	2	SZ	SN	SN	SN	SN		SN	SN
		٠							
VMP3-6	SN		SN	0.00049	0	SN		10	SN
VMP3-11	S.Z.	SN	NS	0.00020	0	SN	0.00039	0	SN
VAVD2 20	SN		SN	0.0	0	SN	0.0	0	SN
VIVIES—30) (SIA	0.0		V2
VMP3-55	0.00063	0	N Z	0.0	0	CK!			2
VW1	SN	NS	SN	NS	SN	SN	0.0	0	SN
! : :									

Notes:

/a = Not Sampled.
/b = Milligrams hydrocarbons per kilogram soil per year.
/c = Assumes moisture content of the soil is average of initial and final moistures.

INITIAL AND 1-YEAR SOIL AND SOIL GAS ANALYTICAL RESULTS BEALE AFB, CALIFORNIA TABLE 2 SITE 18

A (T Tt.) a/			Sample Locations – Depth	ions – Depth		
Allatyte (Omto)	ΔΛ	VW-1	VMP1-6	-6	VMP3-6	9-
Soil Gas Hydrocarbons	Initial ^{b/}	1-Year ^{c/}	Initial	1-Year	Initial	1-Year
TVH (nnmv)	1.500	3.2	1,400	840	7,900	4,100
Benzene (ppmv)	2.0	<0.002	1.1	<0.05	31	14
Toluene (ppmv)	0.65	<0.002	1.1	<0.05	3.0	<0.51
Ethylbenzene (ppmv)	2.1	<0.002	1.2	1.0	2.7	1.4
Xylenes (ppmv)	2.3	<0.002	2.4	1.7	0.76	3.5
	MA	VW1-11	VMP1-12	12	VMP2-11	-11
Soil Hydrocarbons	Initial ^d	1-Year ^{e/}	Initial	1-Year	Initial	1-Year
TRPH (mg/kg)	24,000	16,500	40,000	11.7	3,900	354
Benzene (mg/kg)	<1.6	<0.16	<0.41	<0.069	<0.4	<0.17
Toluene (mg/kg)	2.0	<0.16	0.75	<0.069	1.5	<0.17
Ethylbenzene (mg/kg)	6.7	<0.16	0.52	<0.069	2.7	<0.17
Xylenes (mg/kg)	16	<0.23	<0.62	<0.097	7.8	<0.24
Moisture (%)	24.8	24.5	26.9	10.1	26.5	24.8

a/ TVH = total volatile hydrocarbons; ppmv = parts per million, volume per volume;

TRPH = total recoverable petroleum hydrocarbons; mg/kg = milligrams per kilogram;

^{b/} Initial soil gas samples collected on November 12, 1992

c' Final soil gas samples collected on January 22, 1994

NS = not sampled

d'Initial soil samples collected on November 2-3, 1992

e' Final soil samples collected on March 15, 1994

RESPIRATION AND DEGRADATION RATES CHARLESTON AFB, SOUTH CAROLINA SITE FT-03 TABLE 1

	Init	Initial = November 1992	r 1992	- 9	6-Month = May 1993	1993	1-Y	1 - Year = November 1993	er 1993
	Ko Ko	Degradation	t	K _o	Degradation	Soil	K _o	Degradation	Soil
Location - Depth	(% O ₂ /mm)	(mg/kg/year) ^{b/}	1 emperature (°C)	(% O ₂ /min)	Kate- (mg/kg/year)	(°C) (% O ₂ /min)	(% O ₂ /min)	Kate (mg/kg/year)	l emperature (^O C)
MPA-3.5	$^{/\! m e}V$	NA	NA	0.0046	270	19.7	0.00085	120	16.9
MPB-3.5	NA	NA	NA	0.0018	110	NS	0.00045	09	NS
MPC-3.25	NA	NA	NA	/SN	NS	NS	0.00036	70	NS
MPD-1.8 MPD-3.9	NA 0.008	NA 580	NA 19.0	0.0031	370	NS 19.3	0.0028	510	NS 773

a/Not Available – Point was submerged.
b/Milligrams hydrocarbons per kilogram soil per year.
c/Not Sampled.
d/Assumes moisture content of the soil is average of initial and final moistures.

INITIAL AND 1-YEAR SOIL AND SOIL GAS ANALYTICAL RESULTS CHARLESTON AFB, SOUTH CAROLINA SITE FT-03 TABLE 2

		Saı	mple Local	Sample Location-Depth	ų	
Analyte (Units) ²⁰		(fee	t below gro	(feet below ground surface	(e)	
	MPA-3.5	-3.5	MPC-3.25	-3.25	MPD-3.9	-3.9
Soil Gas Hydrocarbons	Initial ^{b/}	1-Year	Initial	1-Year	Initial	1-Year
TVH (ppmv)	27	0.47	$NS^{q/}$	0.78	790	13
Benzene (ppmv)	<0.002	< 0.002	SN	< 0.002	<0.04	< 0.002
Toluene (ppmv)	<0.002	< 0.002	SN	< 0.002	<0.04	< 0.002
Ethylbenzene (ppmv)	<0.002	< 0.002	SN	0.002	0.12	< 0.002
Xylenes (ppmv)	0.002	<0.002	NS	<0.002	0.22	<0.002
	VW-3.5	-3.5	MPA-2.5	-2.5	MPD-3	-3
Soil Hydrocarbons	Initial ^{e,}	$1-\mathrm{Year}^{t'}$	Initial	1-Year	Initial	1-Year
TRPH (mg/kg)	1,100	170	51	12	2,200	2,200
Benzene (mg/kg)	<0.73	< 0.0027	<0.72	<0.0006	<1.4	<0.54
Toluene (mg/kg)	2.6	< 0.0027	2.7	<0.0006	<1.1	<0.54
Ethylbenzene (mg/kg)	1.6	< 0.0027	9.0>	<0.0006	<1.6	<0.54
Xylenes (mg/kg)	4.6	<0.0038	1.3	<0.0006	<2.1	<0.75
Moisture (%)	17.9	8.5	16.8	9.1	12.6	9.9

[&]quot; TRPH=total recoverable petroleum hydrocarbons; mg/kg=milligrams per kilogram;

TVH = total volatile hydrocarbons; ppmv=parts per million, volume per volume; b Initial soil gas samples collected on May 6, 1993

9' Final soil gas samples collected on November 11, 1993

d' NS=not sampled.

⁴ Initial soil samples collected on October 29, 1992
⁴ Final soil samples collected on November 11, 1993